


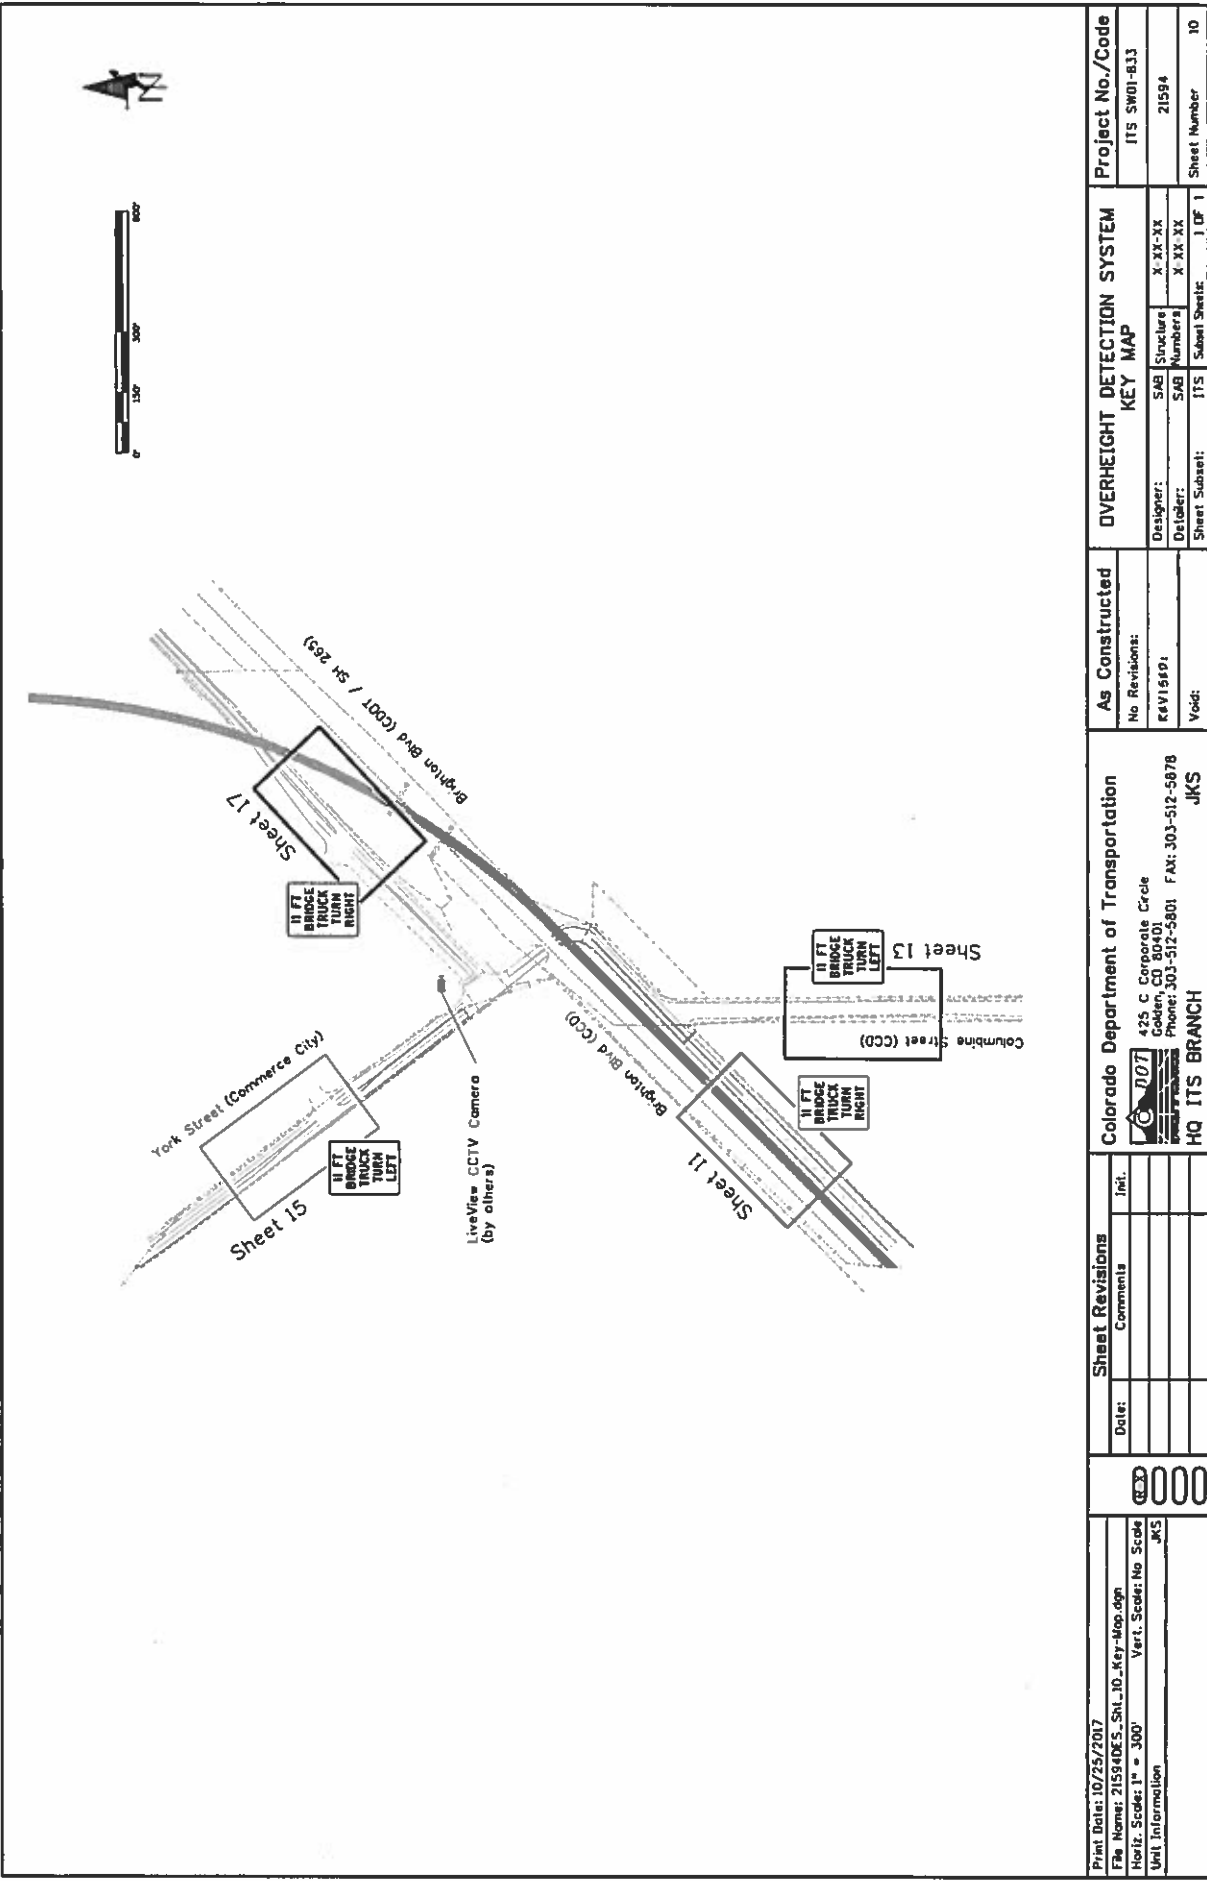

Print Date: 10/25/2017		Sheet Revisions		Colorado Department of Transportation		As Constructed		OVERHEIGHT DETECTION SYSTEM		Project No./Code	
File Name: 21594DES_Sht_10_Key-Map.dgn		Date:		425 C Corporate Circle		No Revisions:		KEY MAP		ITS SW01-B33	
Horiz. Scale: 1" = 300'		Comments		 425 C Corporate Circle		REV1559:		SAB		21594	
Unit Information				Golden, CO 80014		Void:		SAB Numbers		Sheet Number	
				Phone: 303-512-5801 FAX: 303-512-5878				SAB		10	
				HQ ITS BRANCH				SAB Subsets		JDF 1	
								SAB			
								SAB			
								S			