


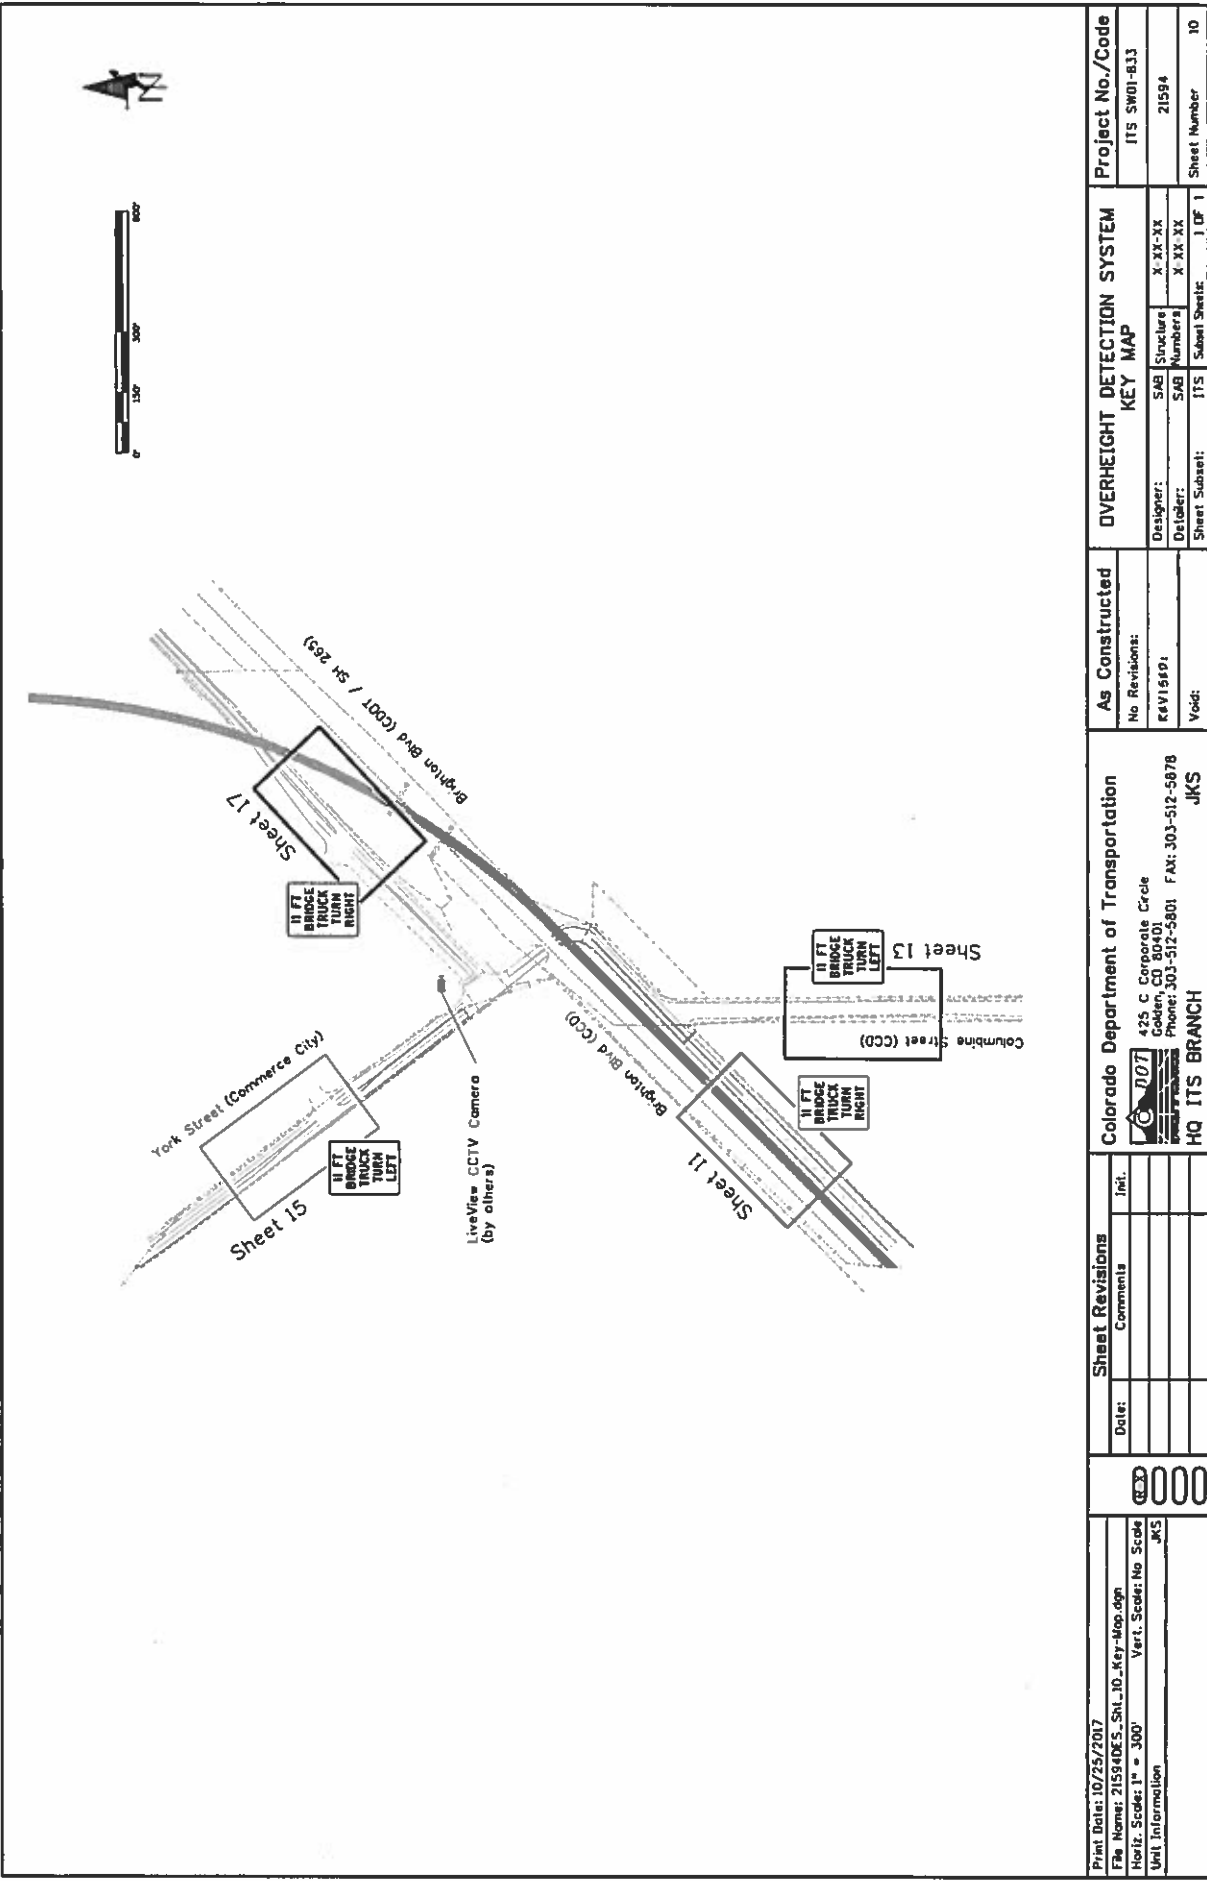

Print Date: 10/25/2017 File Name: 21594DES_Sht_10_Key-Map.dgn Horiz. Scale: 1" = 300' Vert. Scale: No Scale Unit Information		Sheet Revisions Date: _____ Comments _____ Init. _____ _____		Colorado Department of Transportation 125 C Corporate Circle CO 80501 Phone: 303-512-5801 FAX: 303-512-5878 HQ ITS BRANCH		As Constructed No Revisions: K&V1559: Void:		OVERHEIGHT DETECTION SYSTEM KEY MAP Designer: SAB Structure Number: X XX-XX Detailer: SAB SAB Number: X XX XX Sheet Subset: ITS Sheet Subset: 1 OF 1		Project No./Code ITS SW01-B33 21594 Sheet Number 10	
--	--	--	--	---	--	--	--	--	--	--	--

Colorado Department of Transportation
 425 C Corporate Circle
 Golden, CO 80601
 Phone: 303-512-5801 FAX: 303-512-5878
 JKS
 HQ ITS BRANCH